


No: 558

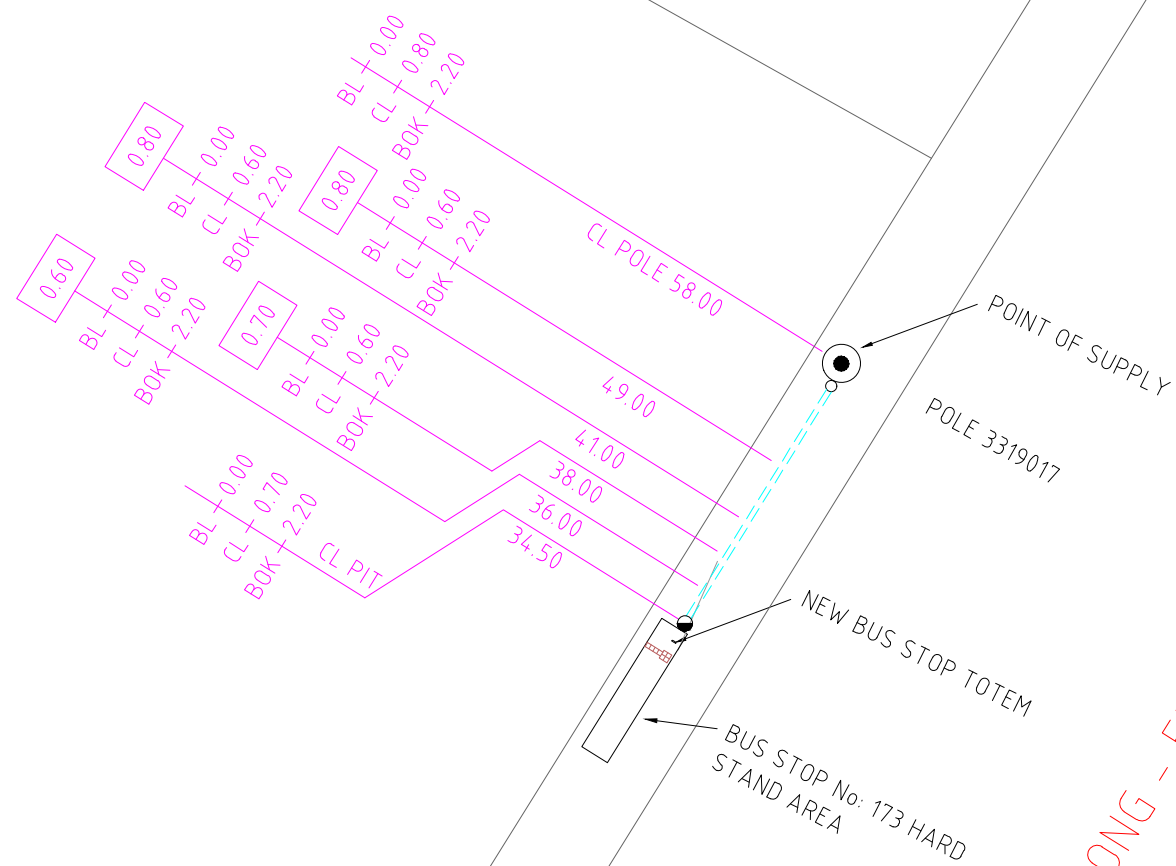

DANDENONG - FRANKSTON ROAD


No: 1235

LATHAMS ROAD

**NOTE:**

This plan is a representation of a cable ('asset') that is not owned or maintained by United Energy Distribution Pty Limited ('UEDPL'). UEDPL and its employees, contractors and agents make no representations as to the accuracy of this plan. All inquiries about this asset should be directed to the asset owner listed below. You will need to obtain its full terms and conditions to carry out excavations within the vicinity of this asset.

The asset owner must also comply with relevant regulatory requirements including the Electricity Safety Act 1998 ('the Act') relating to relocating existing assets and installing new or additional assets. If, under the Act, the asset owner is required to re-submit modifications to this plan to UEDPL, it should ensure that any such modifications meet UEDPL's minimum plan standards.

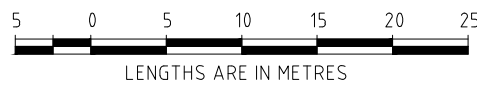

**LEGEND**

- U.G. CABLE
- - - - PUBLIC LIGHTING CABLE 6mm<sup>2</sup>
- SERVICE PIT
- VIC ROADS PIT
- CABLE HEAD POLE:- HV/LV
- U.G. CONDUIT
- - - - O/H CONDUCTOR
- LV POLE
- 1.25 DEPTH OF EARTH COVER TO TOP OF CABLE
- 0.75 DEPTH TO TOP OF OTHER SERVICES/OBSTRUCTIONS

**NOTE: CONDUIT & CABLE SIZES MUST BE SHOWN**

CONDUIT SIZE	63mm
CABLE SIZE	16mm 2/c Cu. x

"For use on the United Energy Distribution Network Only"

REVISION	DATE	REV	DESCRIPTION	CHKD	APPR
		/			
		/			
		/			
		/			

**REFERENCES**

ASSET OWNER, CONTACT No: Department of Transport "CONTACT NAME" - 8688 0000
ASSET OWNER REF & DISTRIBUTION NIMI No: C172, MetLink No:1311, NIMI 123456789
DATE INSTALLED: 28/12/08
MAP: MELWAY MAP PAGE: 100 E2

ASSET OWNER  
DEPARTMENT OF TRANSPORT

ELECTRICAL DISTRIBUTION NETWORK OWNER  
**united energy**

DRAWN XYZ 1/1/09	DRG No. UE5-PRV-XXXXXX
DESIGN CHECKED XYZ 10/1/09	AS BUILT FOR ALL DEVICES SMART BUS SIGN DANDENONG-FRANKSTON RD CARRUM DOWNS
ASSET OWNERS APPROVAL [Signature]	
UE ACCEPTED 25/1/09	TEMPLATE NAME UE99-PRV-A3 REV: C
	MODEL SPACE
	LANDSCAPE
	DRAWING STATUS CURRENT
	A3

SAMPLE DRAWING ONLY